

KEY

- Existing Parking Bays
- Revoked Parking Bays
- New and Amended Parking Bays
- Existing Parking Restrictions
- Revoked Parking Restrictions
- New and Amended Parking Restrictions

Rev	Revision details	Date			
Status: (tick <input checked="" type="checkbox"/> as appropriate)					
INFORMATION	<input type="checkbox"/>	SURVEY	<input type="checkbox"/>	FEASIBILITY	<input type="checkbox"/>
DESIGN	<input checked="" type="checkbox"/>	TENDER	<input type="checkbox"/>	WORKING DRAWINGS	<input type="checkbox"/>
AS-BUILT	<input type="checkbox"/>				
Drawn:	Signed Ben Stride	Date July 2016			
Designed:	Ben Stride	July 2016			
Checked:					
Approved:					
File/Acad ref:	S:\				




Project Name
**RSCH 3Ts Redevelopment Project
 Offsite Highway Works**

Drawing Title
**CPZ H Eastern Road / Arundel Road
 TRO Drawing Eastern Section**

Drawing No HD-BHCC-RSCH/TR02	Scale N.T.S. @ A3	Rev -
---------------------------------	----------------------	----------

Reproduced from the Ordnance Survey mapping with the permission of the Controller of H.M. Stationary Office. © Crown copyright. Unauthorised reproduction infringes Crown copyright and may lead to prosecution or Civil Proceedings. Brighton & Hove City Council, Licence: 100020999, 2016.

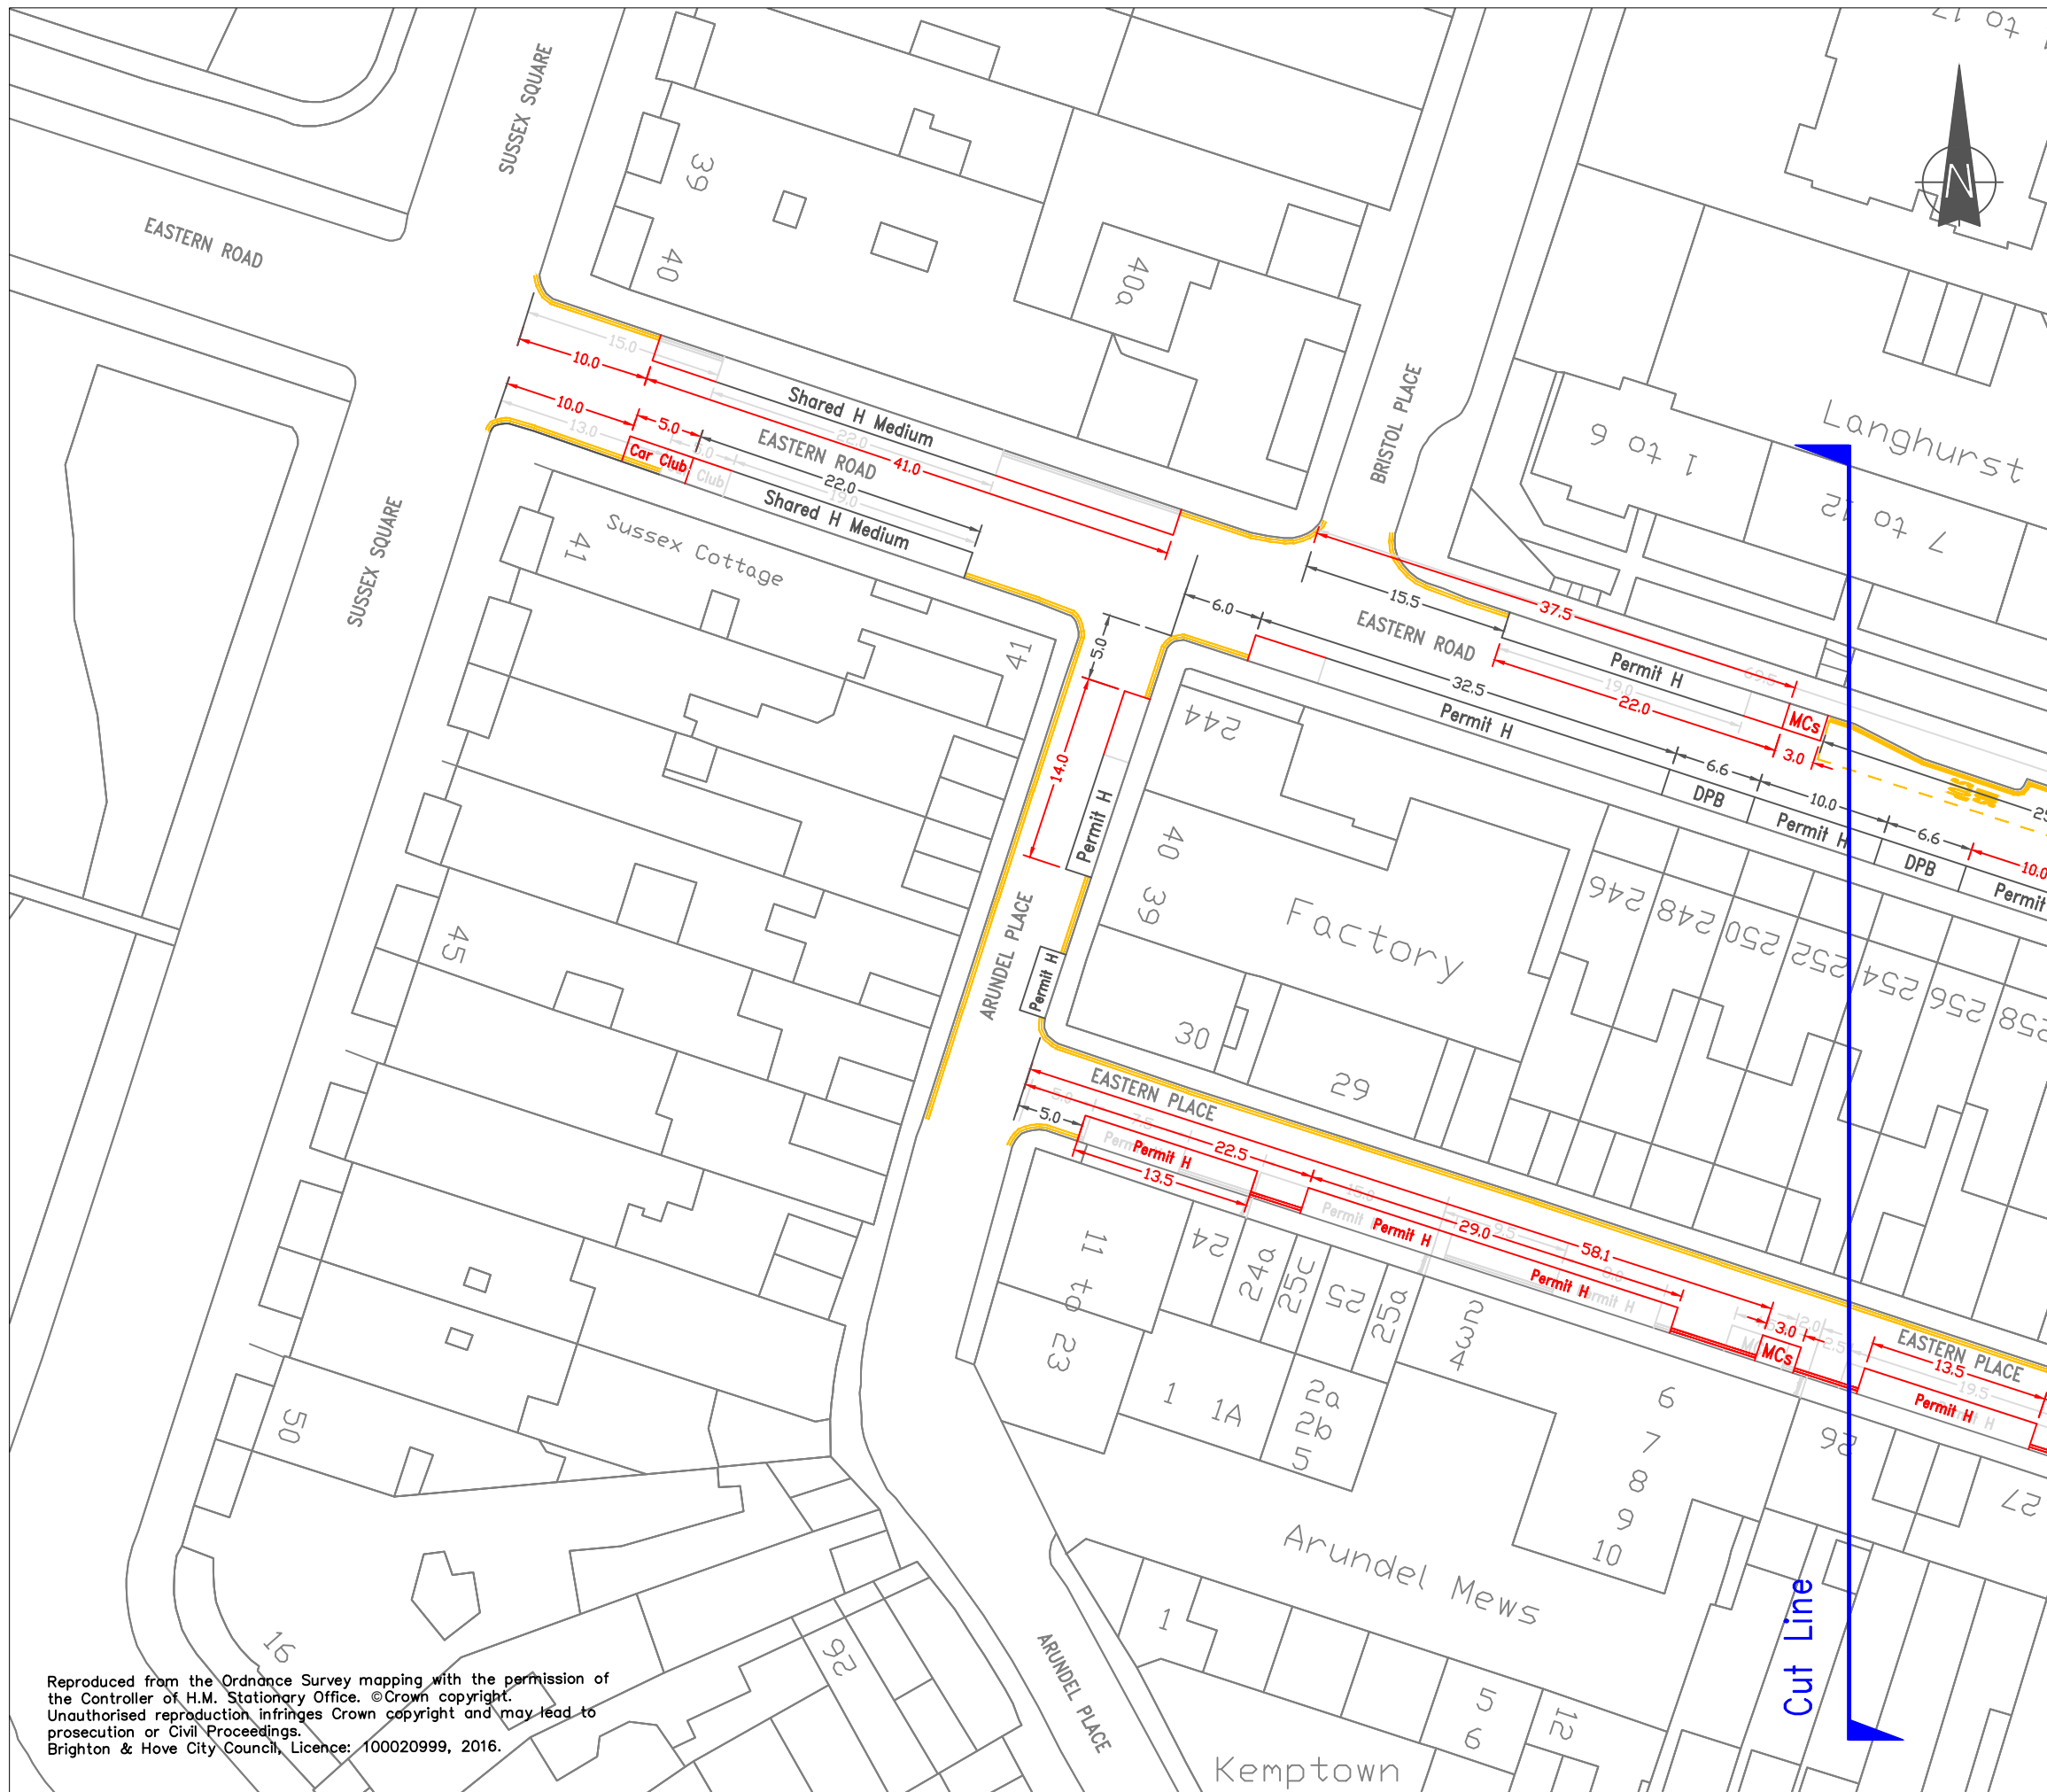

KEY

- Existing Parking Bays
- Revoked Parking Bays
- New and Amended Parking Bays
- Existing Parking Restrictions
- Revoked Parking Restrictions
- New and Amended Parking Restrictions

Rev	Revision details	Date	
Status: (tick <input checked="" type="checkbox"/> as appropriate)			
INFORMATION	<input type="checkbox"/>	SURVEY <input type="checkbox"/>	FEASIBILITY <input type="checkbox"/>
DESIGN	<input checked="" type="checkbox"/>	TENDER <input type="checkbox"/>	WORKING DRAWINGS <input type="checkbox"/>
AS-BUILT	<input type="checkbox"/>		
Signed		Date	
Drawn:	Ben Stride	July 2016	
Designed:	Ben Stride	July 2016	
Checked:			
Approved:			
File/Acad ref:	S:\		



Project Name
**RSCH 3Ts Redevelopment Project
 Offsite Highway Works**

Drawing Title
**CPZ H Eastern Road / Arundel Road
 TRO Drawing Western Section**

Drawing No HD-BHCC-RSCH/TR01	Scale N.T.S. @ A3	Rev -
---------------------------------	----------------------	----------

Reproduced from the Ordnance Survey mapping with the permission of the Controller of H.M. Stationary Office. ©Crown copyright. Unauthorised reproduction infringes Crown copyright and may lead to prosecution or Civil Proceedings. Brighton & Hove City Council, Licence: 100020999, 2016.